



Deposit
JUL 07 2009

P.O. Box 24819
San Jose, California 95154

Office (408) 377-9990

Fax (408) 492-1006

Invoice

CUSTOMER NAME
FRANS VAN WIJK 15970 MONTEBELLO RD. CUPERTINO, CA 95014

DATE	INVOICE #
7/1/2009	ASJ-09-022

QUANTITY	DESCRIPTION	P.O. #	TERMS	RATE	AMOUNT
	JOB SITE: 15970 FLINTLOCK RD., CUPERTINO CALLED IN BY: COLDWELL BANK - MARK BURNS (408)777-2083				
1	SEPTIC PUMP - PUMPED OUT BOTH COMPARTMENTS OF SEPTIC TANK. BOTH SIDES WERE WASHED OUT WITH WATER TO REMOVE ALL SLUDGE.			325.00	325.00
1	INSPECTION - ONE COMPLETE INSPECTION OF SEPTIC TANK.			125.00	125.00
1	1 HR. LABOR EXPOSING LIQUID SIDE OF TANK.			159.50	159.50
<p style="text-align: center;">READ AND APPROVED</p> <p>BY: <u>[Signature]</u></p> <p>BY: <u>Frans Wijk-Hochhaus</u></p> <p>DATE: <u>7/1/09</u></p>		<p>C/2# 7563 \$ 609.00 d/b: 6/30/09</p>			
IT WAS A PLEASURE WORKING WITH YOU. WE LOOK FORWARD TO WORKING WITH YOU IN THE FUTURE.				TOTAL	\$609.50
				PAYMENT / CREDITS	\$0.00
				BALANCE DUE	\$609.50

Underground Construction: Septic - Sewer - Storm - Water - Excavated & Installed Septic Systems: Designed - Installed
 Repaired - Pumped - Inspected Plumbing Sewer & Drain: Line Cleaning - Rodding - Repaired - Replaced - Residential & Commercial
 Vacuum: Septic - Sewer - Storm - Grease Traps/Interceptors Hydro Flushing: Sewer - Storm - Maintenance - Public Works - Overflow
 & Spill Response - Main Line Stoppages Pipeline Video Inspection: 2' To 72" Pipeline Inspection - Line Locating - Detailed Reports
 With Digital Photos Certified: Confined Space Entry - Traffic Control - Trench Safety Complete 24 Hr. Emergency Service



P.O. Box 24819
San Jose, California 95154

Office (408) 377-9990
Fax (408) 492-1008

JUL 07 2009

SEPTIC TANK INSPECTION REPORT

DATE: 6-30-09 INVOICE NO: ASI-09-022

JOB SITE: 15970 Flintlock Rd. Cupertino, CA 95014

BUYERS: SELLERS: Franz Van Wijk

REALTY COMPANY: Coldwell Banker AGENT: Mark Burns PHONE: 408.777.2083

ADDRESS: FAX:

CUSTOMER HAS CESSPOOL () SUMP () SEPTIC TANK (X)

IS UNIT ALL CONCRETE (X) CONCRETE WITH WOOD () TANK ALL WOOD ()

IF TANK HAS WOOD TOP, HOW MANY LAYERS: ONE () TWO ()

CONDITION OF WOOD: GOOD () FAIR () ROTTEN ()

INLET /OUTLET (ELBOWS): GOOD (X) IF BAD/BROKEN WHICH: INLET () OUTLET ()


DOES UNIT NEED PUMPING: YES (X) NO () ESTIMATED GALLONS: 1,250-1,500

DID ABLE PUMP TANK: YES (X) NO () DATE PUMPED: 6-30-09

DOES LIQUID LEVEL INDICATE LEECHING APPEARS TO BE IN WORKING ORDER: YES (X)

FAILED () OR QUESTIONABLE ()

ANY EVIDENCE OF SEWAGE OR SEWER WATER BREAKING OUT OF GROUND: YES () NO (X)

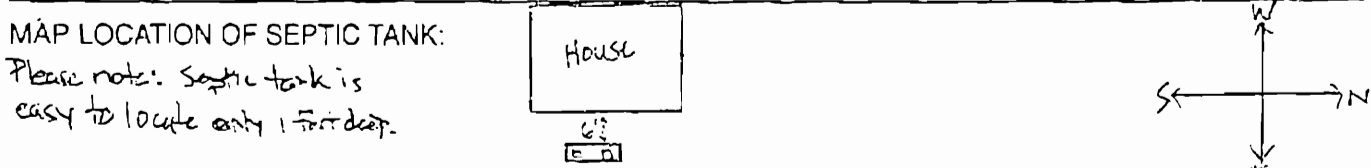

COMMENTS, IF ANY: *THIS IS NO GUARANTEE ON HOW LONG SYSTEM WILL LAST

I completed a 30 minute water test through 4" outlet pipe. The leach field accepted the water test at the present time. I noticed that septic tank was installed in 3 separate pieces and the bottom and middle shifted over about 2" and should be re-sealed. The liquid access lid area is deteriorating from the inside through to the outside. There is a replacement wood lid over liquid compartment access lid. should keep an eye on it next service.

REPORT COMPLETED BY: John Marshall Tank was resealed on 7/1/09.

Underground Construction: Septic • Sewer • Storm • Water • Excavated & Installed Septic Systems: Designed • Installed Repaired • Pumped • Inspected Plumbing Sewer & Drain: Line Cleaning • Rodding • Repaired • Replaced • Residential & Commercial Vacuum: Septic • Sewer • Storm • Grease Traps/Interceptors Hydra Flushing: Sewer • Storm • Maintenance • Public Works • Overflow & Spill Response • Main Line Stoppages Pipeline Video Inspection: 2" To 72" Pipeline Inspection • Line Locating • Detailed Reports With Digital Photos Certified: Confined Space Entry • Traffic Control • Trench Safety Complete 24 Hr. Emergency Service

